

Exhibit 4- Boundary area discrepancies with AT&T
attempts to Resolve and map that support
our boundaries.



64 N Clark • Sullivan, MO • 63080 • 573-468-1223 • 573-468-5440 • 800-392-8070

July 12, 2014

Ms. Chelsea Fallon
Federal Communication Commission
Via Email: Chelsea.Fallon@fcc.gov

RE: Study Area Boundary Discrepancy with AT&T – Process for conforming data to
eliminate overlaps

Dear Ms. Fallon,

We are in receipt for your correspondence dated June 20, 2014, regarding study area boundary overlaps between our Company and AT&T. Please be advised that on March 14, 2014 we responded to AT&T in regards to their boundary map discrepancies and believe our maps are accurate in all aspects and that AT&T encroaches on Fidelity's incumbent service areas.

As showed in the attached information submitted to AT&T on March 14 we have followed the FCC's order to resolve mapping inconsistencies and pursuant to your letter have again made a request to AT&T to resubmit and recertify the boundaries to the FCC.

If you have any questions or concerns, feel free to contact me at (573) 468-1218 or carla.cooper@fidelitycommunications.com.

Respectfully,

FIDELITY COMMUNICATIONS CO.

A handwritten signature in blue ink that reads 'Carla Cooper'.

Carla Cooper
Director of Revenue Accounting

Enclosure
CC: john.emmett@fcc.gov



64 N Clark • Sullivan, MO • 63080 • 573-468-8081 • 573-468-5440 • 800-392-8070

July 1, 2014

Gregory Wagner
AT&T
Via Email: gw5604@att.com

RE: Study area discrepancy boundary with AT&T

Dear Mr. Wagner,

We recently received correspondence from the FCC indicating that there continues to be a study area boundary overlap with AT&T and our Company. Fidelity responded to AT&T's claim on March 14 that we had reviewed the maps submitted by AT&T as well as the exchange boundary maps approved by and on file with the Missouri Public Service Commission for both Fidelity and AT&T (collectively, the "PSC Maps"), and Fidelity agrees that there are areas of overlap; however, Fidelity disagrees that its service areas encroach upon AT&T's incumbent service territories. Rather, the opposite is the case. That is, AT&T encroaches on Fidelity's incumbent service areas).

We furnished copies of the PSC Maps, as well as a map showing those areas where AT&T's service areas extend into Fidelity's local exchange service boundaries.

Pursuant to the FCC's order establishing procedures to resolve mapping inconsistencies, Fidelity requested AT&T review these PSC Maps and study area boundaries as soon as possible. If AT&T agreed that the boundary maps overlap into Fidelity's authorized exchange service areas, then Fidelity requests that AT&T resubmit and recertify the boundaries by the FCC's March 17, 2014 deadline.

Given AT&T's failure to reply, we can only assume that if a boundary line discrepancy exists, the error lies with AT&T and its boundary maps. We will be notifying the FCC accordingly, and request that you take the necessary action to correct AT&T's boundary maps filed with the FCC. If you have any questions regarding this matter, please contact me at your convenience.

If you have any questions or concerns, feel free to contact me at (573) 468-1218 or carla.cooper@fidelitycommunications.com.

Respectfully,

FIDELITY COMMUNICATIONS CO.

A handwritten signature in blue ink that reads "Carla Cooper".

Carla Cooper
Director of Revenue Accounting



64 N Clark • Sullivan, MO • 63080 • 573-468-1223 • 573-468-5440 • 800-392-8070

March 14, 2014

Mr. Gregory Wagner
AT&T
Via Email: gw5604@att.com

RE: Study Area Boundary Discrepancy with AT&T

Dear Mr. Wagner,

This letter responds to your email dated February 2, 2014, in which you claim that Fidelity Telephone Co. ("Fidelity") service boundaries overlap AT&T incumbent service areas.

Fidelity has reviewed the maps submitted by AT&T as well as the exchange boundary maps approved by and on file with the Missouri Public Service Commission for both Fidelity and AT&T (collectively, the "PSC Maps"), and Fidelity agrees that there are areas of overlap; however, Fidelity disagrees that its service areas encroach upon AT&T's incumbent service territories. Rather, the opposite is the case. That is, AT&T encroaches on Fidelity's incumbent service areas).

I have enclosed for your convenience a copy of the PSC Maps, as well as a map showing those areas where AT&T's service area extend into Fidelity's local exchange service boundaries.

Pursuant to the FCC's order establishing procedures to resolve mapping inconsistencies, Fidelity requests that AT&T review these PSC Maps and study area boundaries as soon as possible. If AT&T agrees that the boundary maps overlap into Fidelity's authorized exchange service areas, then Fidelity requests that AT&T resubmit and recertify the boundaries by the FCC's March 17, 2014 deadline.

If you have any questions or concerns, feel free to contact me at (573) 468-1218 or carla.cooper@fidelitycommunications.com.

Respectfully,


FIDELITY COMMUNICATIONS CO.

A handwritten signature in blue ink that reads 'Carla Cooper'.

Carla Cooper
Director of Revenue Accounting

CC/jlt
Enclosure

ATT Overlap Challenge Area

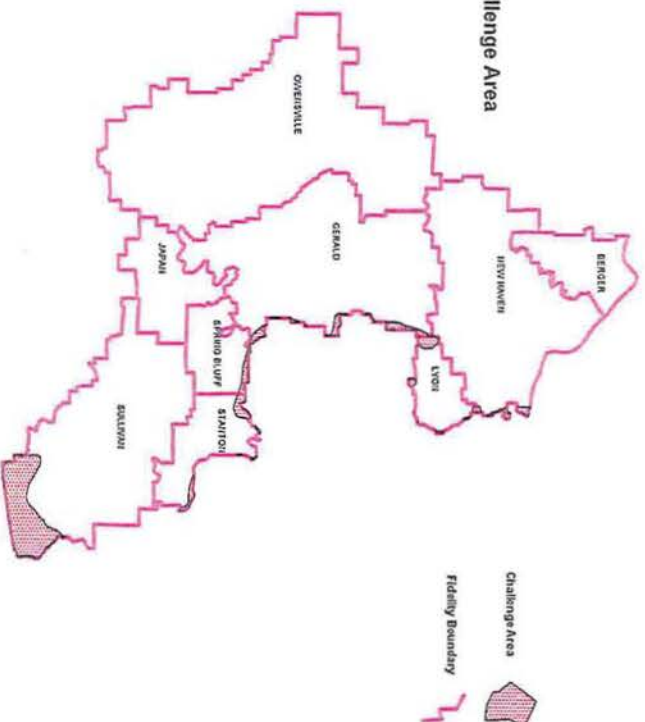

OK

NO SUPPLEMENT TO THIS TARIFF WILL
BE ISSUED EXCEPT FOR THE PURPOSE OF
CANCELING THIS TARIFF.


P. S. C. No. 17

EXCHANGE AREA MAP

REF. AC. 046

Revised Sheet 3
of Revised Sheet 3

Beaufort, Missouri

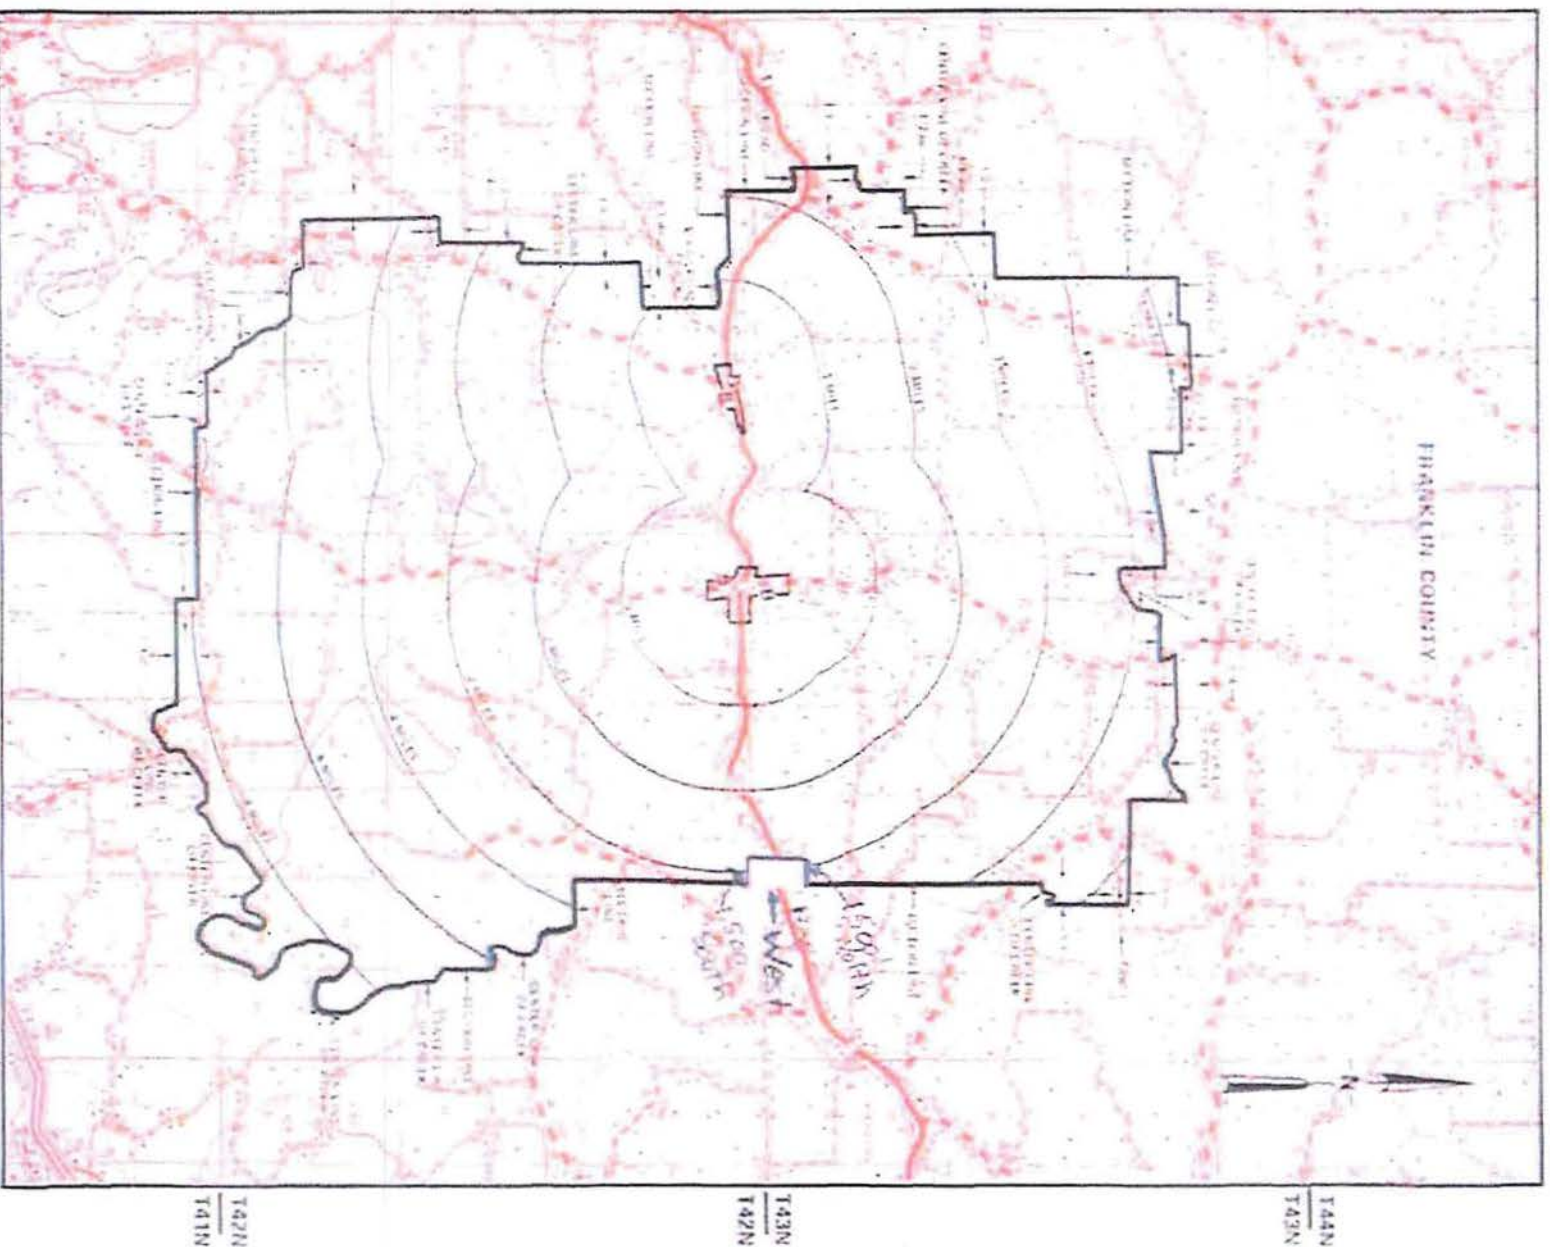

Revised Sheet 3

Issued January 30, 2006

Revised Sheet 3

IS CARRYING THROUGH BY President-Missouri
Southwestern Bell Telephone, L.P., d/b/a AT&T Missouri
St. Louis, Missouri

Effective March 1, 2006

877

NO SUPPLEMENT TO THIS TARIFF WILL
BE ISSUED EXCEPT FOR THE PURPOSE OF
CANCELLING THIS TARIFF.



P. S. C. Mo. No. 17

OK

Washington, Missouri

EXCHANGE AREA MAP

7th REVISED SHEET 3
REPLACING 6th REVISED SHEET 3

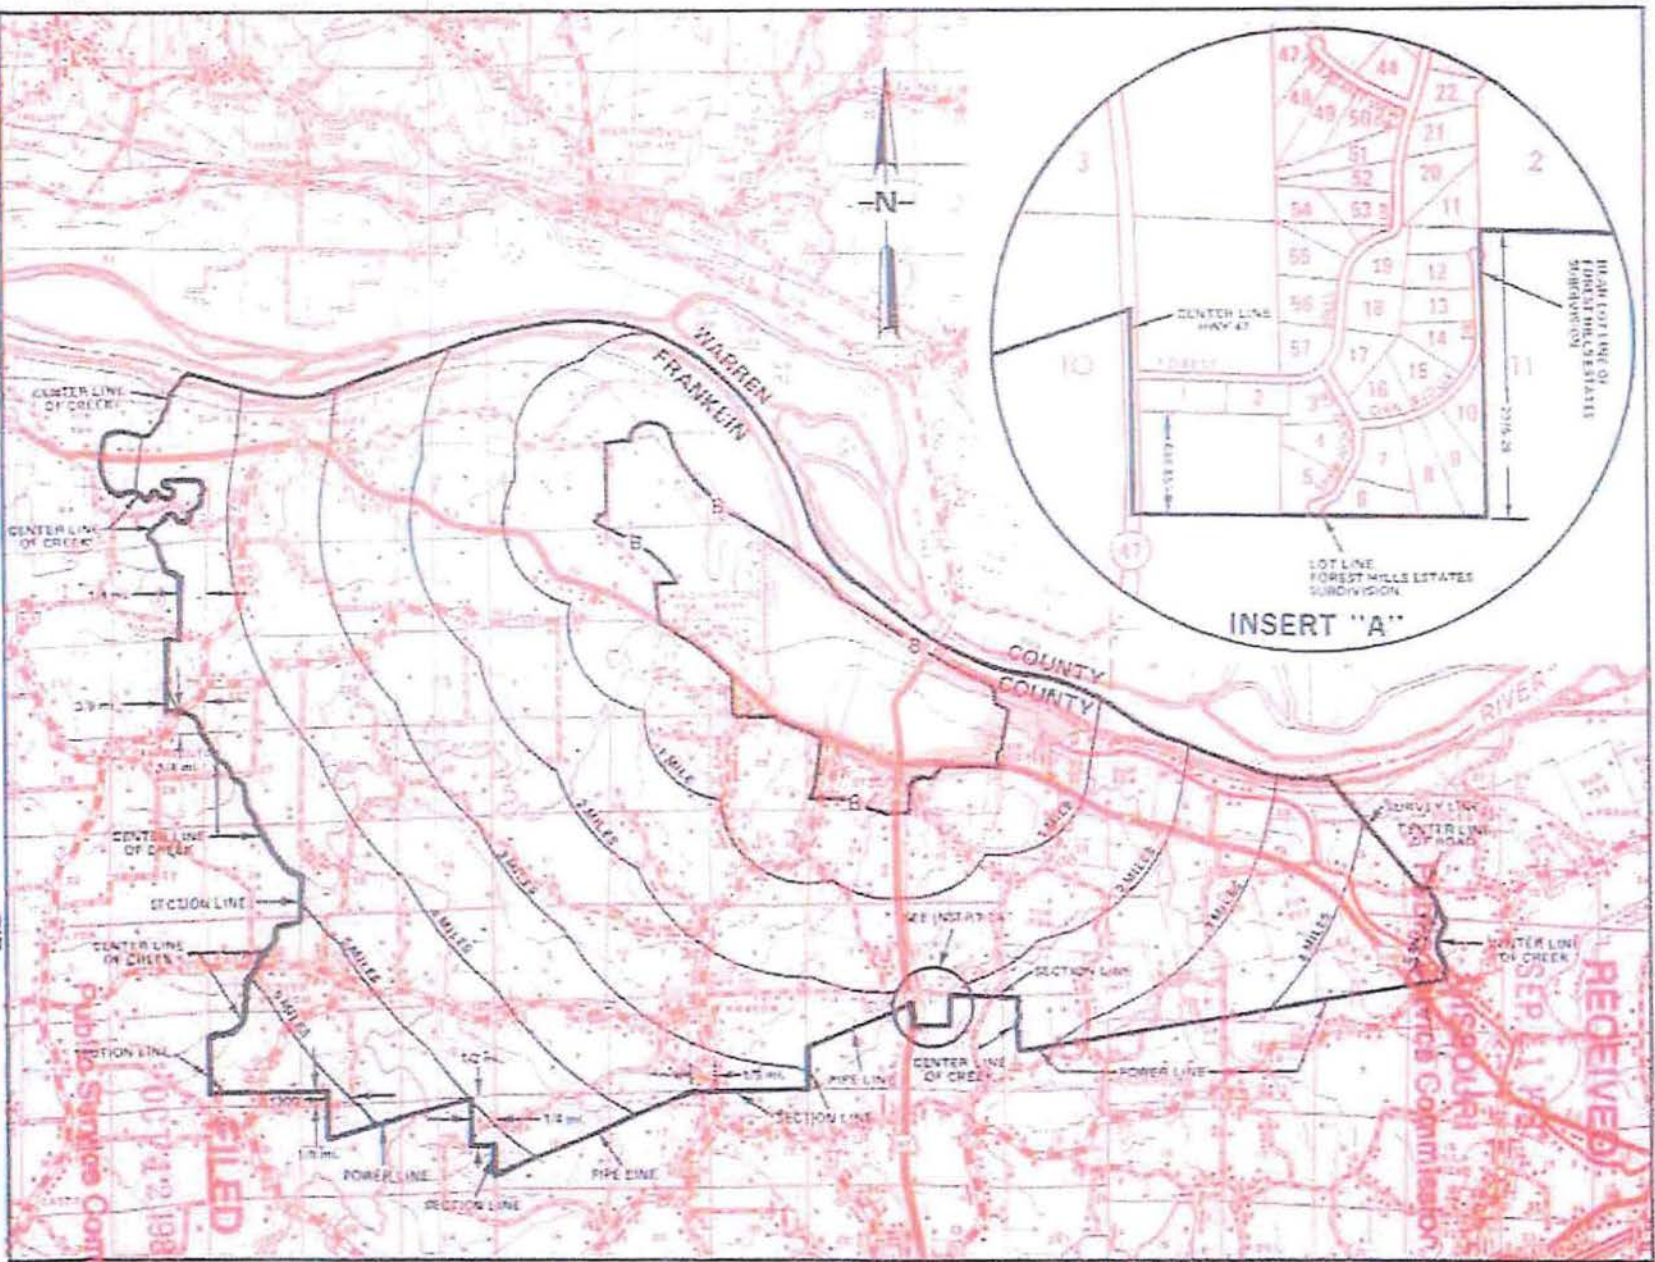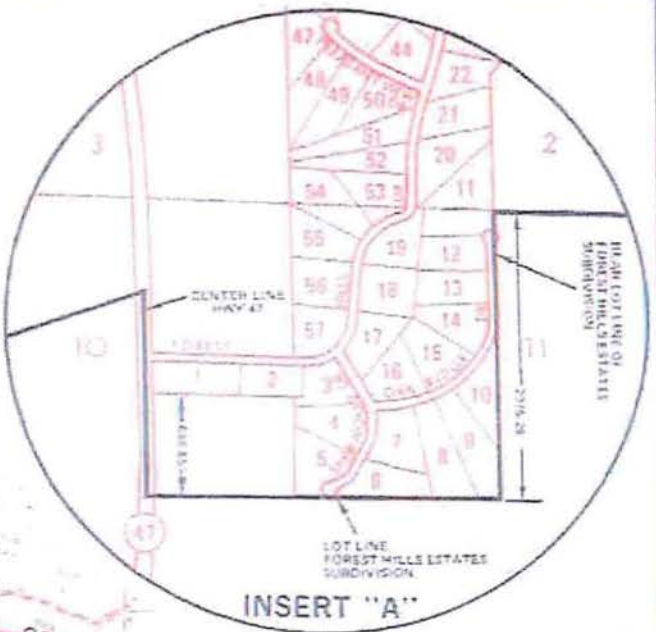

SEP 11 1987

T45N
T44N
By R. D. BARRON, President, Missouri Division
Southwestern Bell Telephone Company

T44N
T43N
OCT 12 1987
NCT 12 1987

Public Service Commission




OK

NO SUPPLEMENT TO THIS TARIFF WILL
BE ISSUED EXCEPT FOR THE PURPOSE OF
CANCELING THIS TARIFF.

P. S. C. Mo. No. 17
EXCHANGE AREA MAP

St. Clair, Missouri

22nd REVISED SHEET 3
REPLACING 21st REVISED SHEET 3

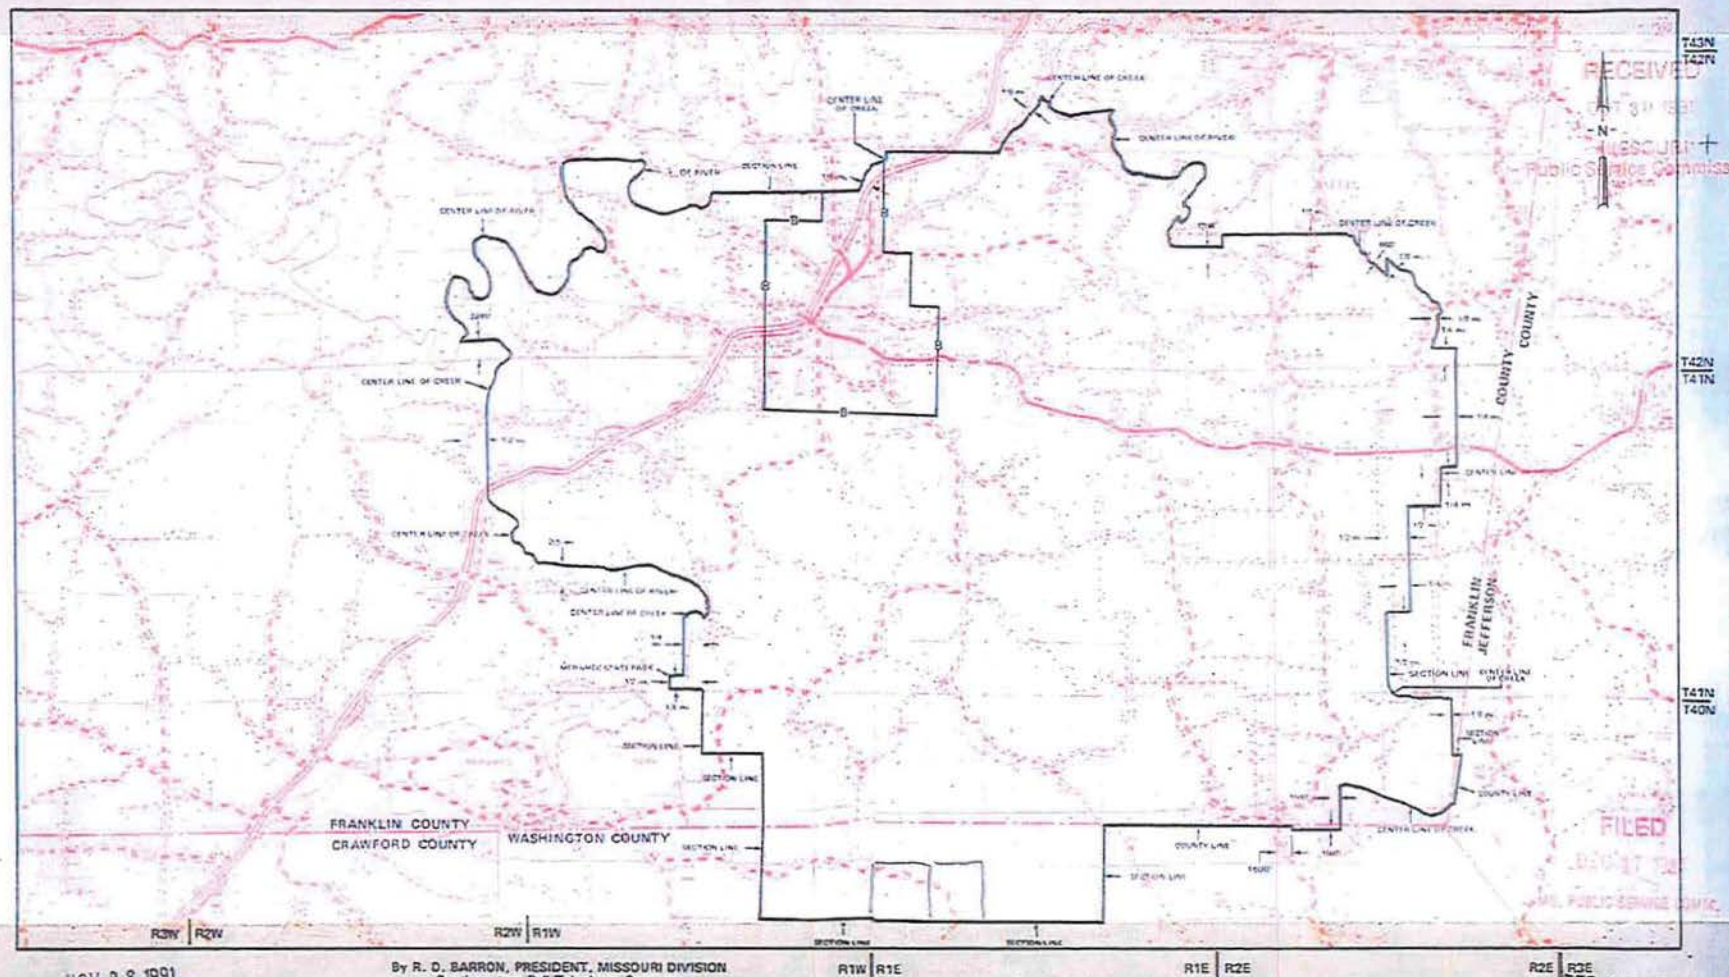

Issued: NOV 08 1991

By R. D. BARRON, PRESIDENT, MISSOURI DIVISION
Southwestern Bell Telephone Company
St. Louis, Missouri

Effective: DEC 17 1991


NO SUPPLEMENT TO THIS TARIFF WILL
BE ISSUED EXCEPT FOR THE PURPOSE OF
CANCELING THIS TARIFF.

P. S. C. Mo. No. 17
EXCHANGE AREA MAP

Richwoods, Missouri

5th REVISED SHEET 3
REPLACING 4th REVISED SHEET 3

MAY 20 1977

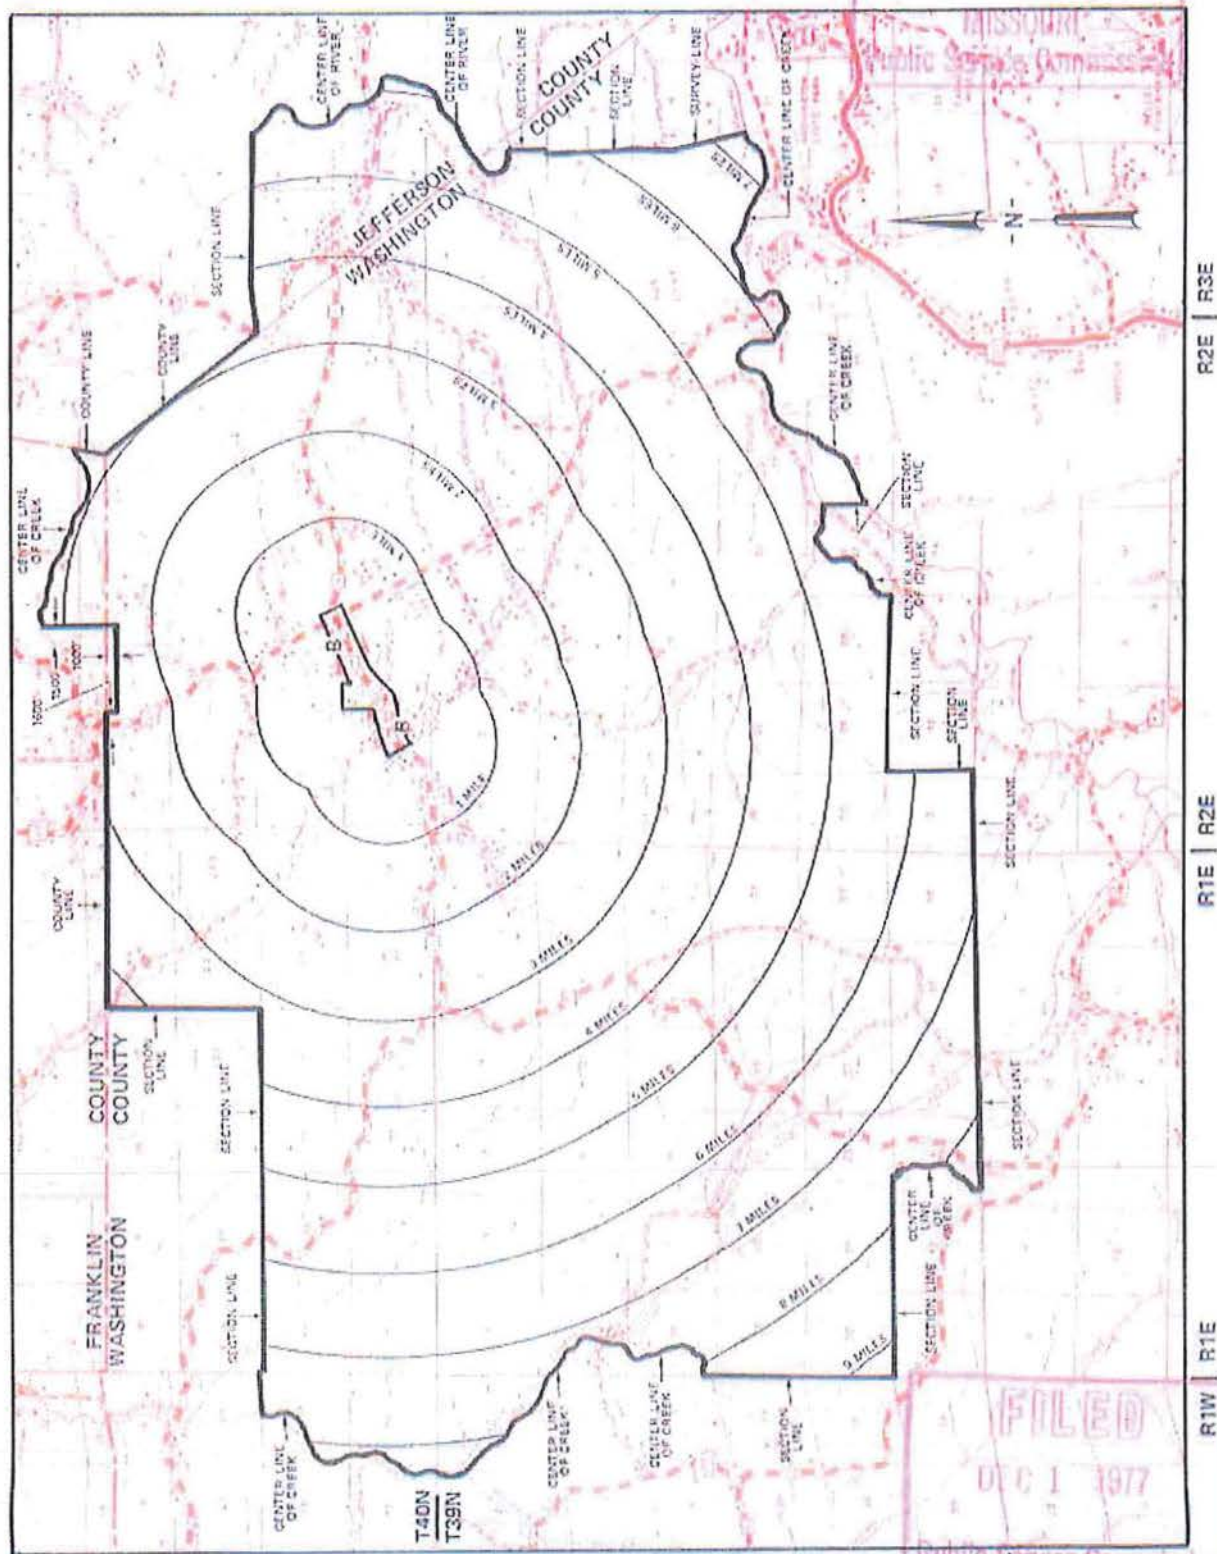

By R. B. SHOCKLEY, Vice President, Missouri
Southwestern Bell Telephone
St. Louis, Missouri


Issued: MAY 23 1977

Effective: DEC 1 1977

FORM NO.13 P.S.C. MO. No. 1 5th (original) Sheet No. 4
(revised)
Cancelling P.S.C. MO. No. 1 4th (original) Sheet No. 4
(revised)
Fidelity Telephone Company For Sullivan, Missouri
Name of Issuing Corporation Community, Town or City
Franklin, Crawford, & Washington
Counties RECEIVED

EXCHANGE AREA MAP

MAR 21 1994

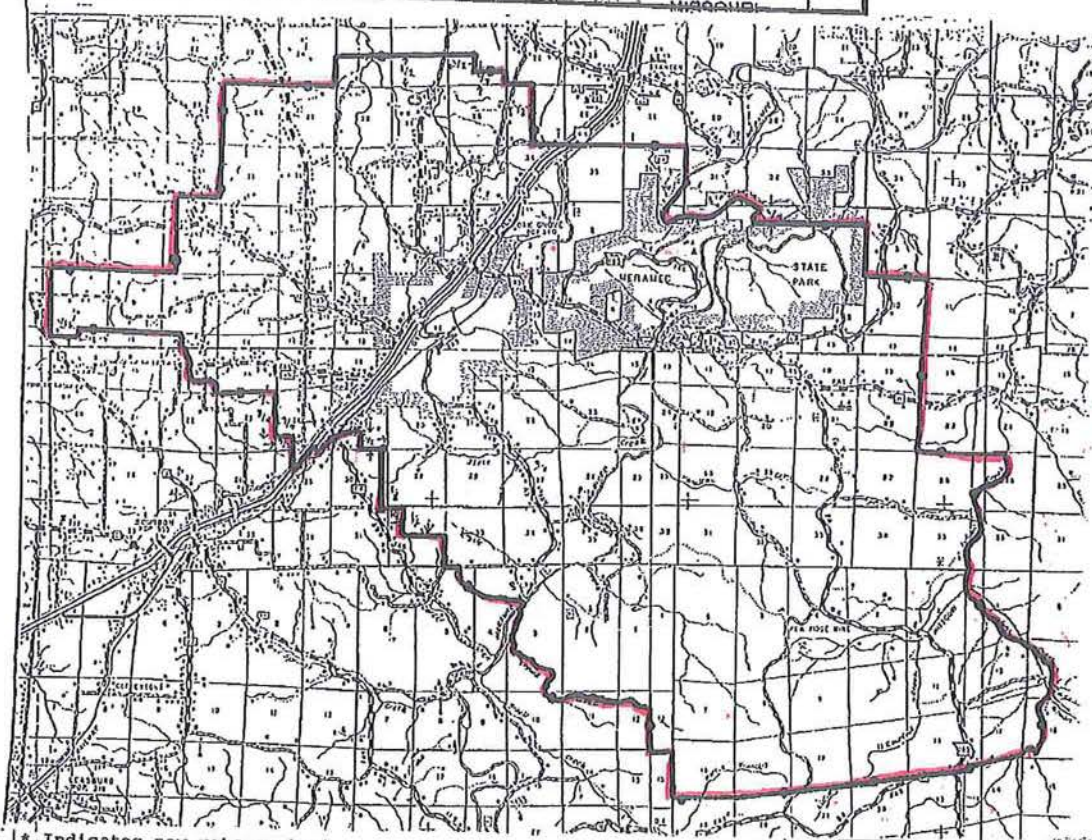


* Indicates new rate or text
+ Indicates change

MISSOURI
Public Service Commission
DATE OF ISSUE March 21, 1994 DATE EFFECTIVE April 20, 1994
month day year month day year
ISSUED BY Ken Matzdorff, Asst. V.P. Revenues, 64 N. Clark Sullivan, MO
name of officer title address

FORM NO. 13 P.S.C.MO. No. 1 3rd ~~XXXXXX~~ SHEET No. 4
Cancelling P.S.C.MO. No. 1 2nd ~~XXXXXX~~ SHEET No. 4
(Revised) (Revised)

FIDELITY TELEPHONE COMPANY For New Haven, Missouri
Name of Issuing Corporation Community, Town or City
Franklin and Gasconade Counties

EXCHANGE AREA MAP

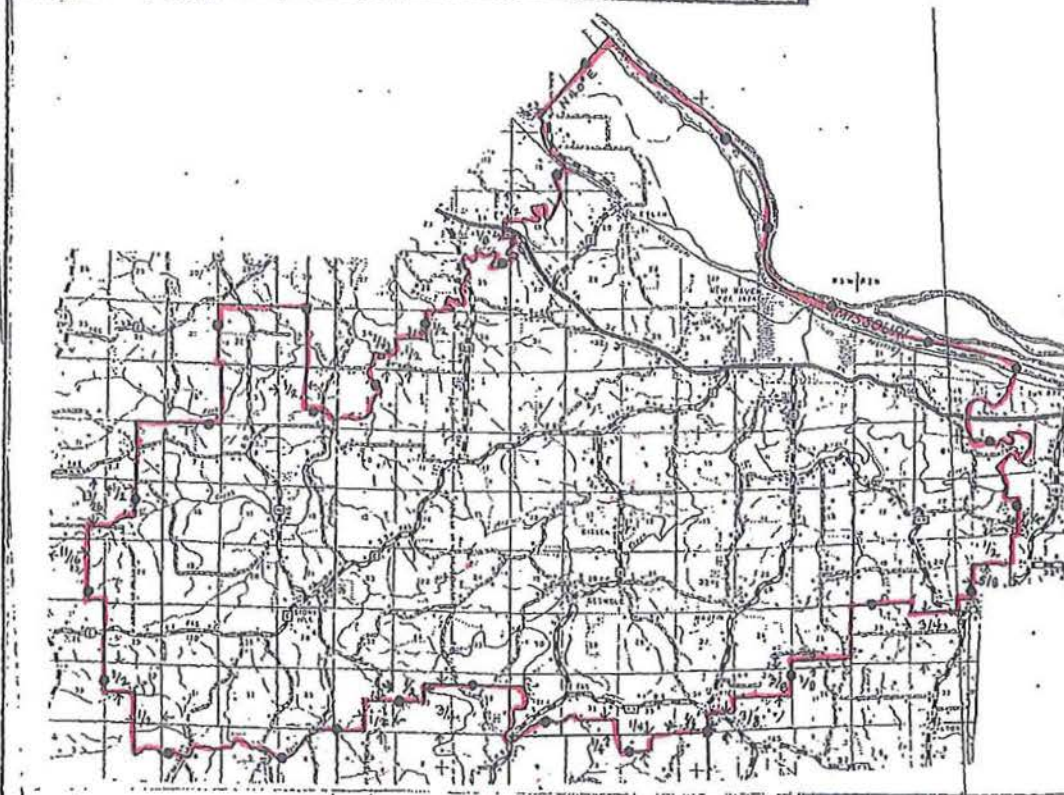


*Indicates new rate or text
+Indicates change

DATE OF ISSUE May 1, 1977 DATE EFFECTIVE June 1, 1977
month day year month day year
ISSUED BY Evan R. Copsey President Sullivan, MO
name of officer title address

FIDELITY TELEPHONE COMPANY
Name of Issuing Corporation

For Lyon, Missouri
Community, Town or City
Franklin County

MISSOURI
Public Service Commission

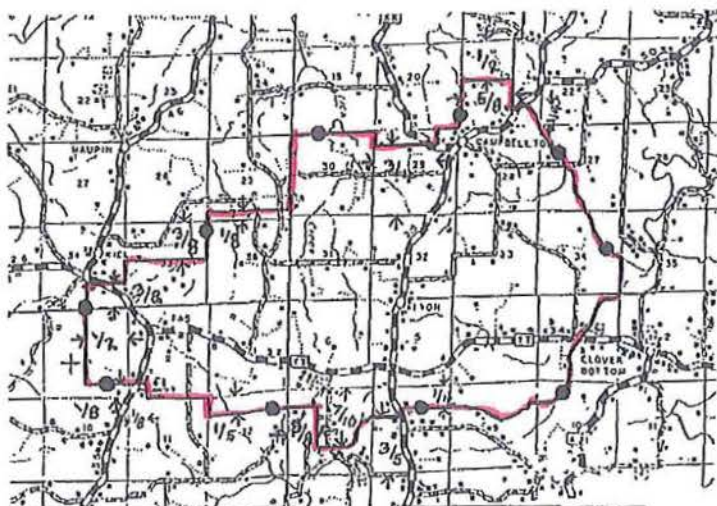

Public Service Commission

DATE OF ISSUE May 1, 1977 DATE EFFECTIVE June 1, 1977
month day year month day year

ISSUED BY Evan R. Copsey President Sullivan, MO
name of officer title address

City Telephone Company


PSC MO. NO. 1

Original Sheet No. 3.1

EXCHANGE AREA MAP FOR GERALD, MO.

Missouri Public
Service Commission

REC'D DEC 01 1998

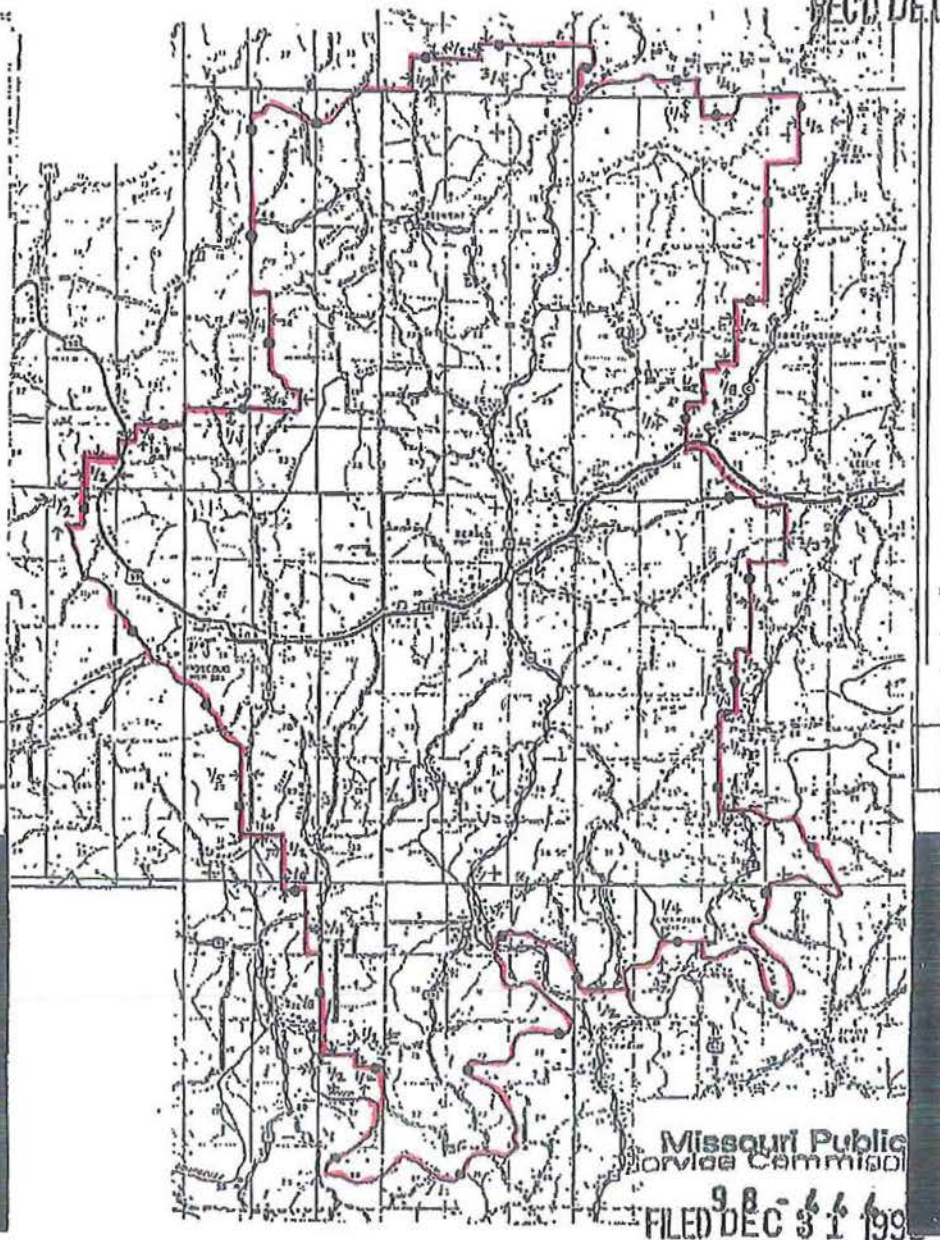


Issued: December 1, 1998

Issuing Officer:
John Davis
64 North Clark
Sullivan, Missouri 63080

Effective: December 31, 1998

FORM NO. 13 P.S.C.MO. No. 1 2nd {~~Original~~
{Revised} SHEET No. 4
Cancelling P.S.C.MO. No. 1 1st {~~Original~~
{Revised} SHEET No. 4

FIDELITY TELEPHONE COMPANY For Spring Bluff, Missouri
Name of Issuing Corporation Community, Town or City
Franklin County

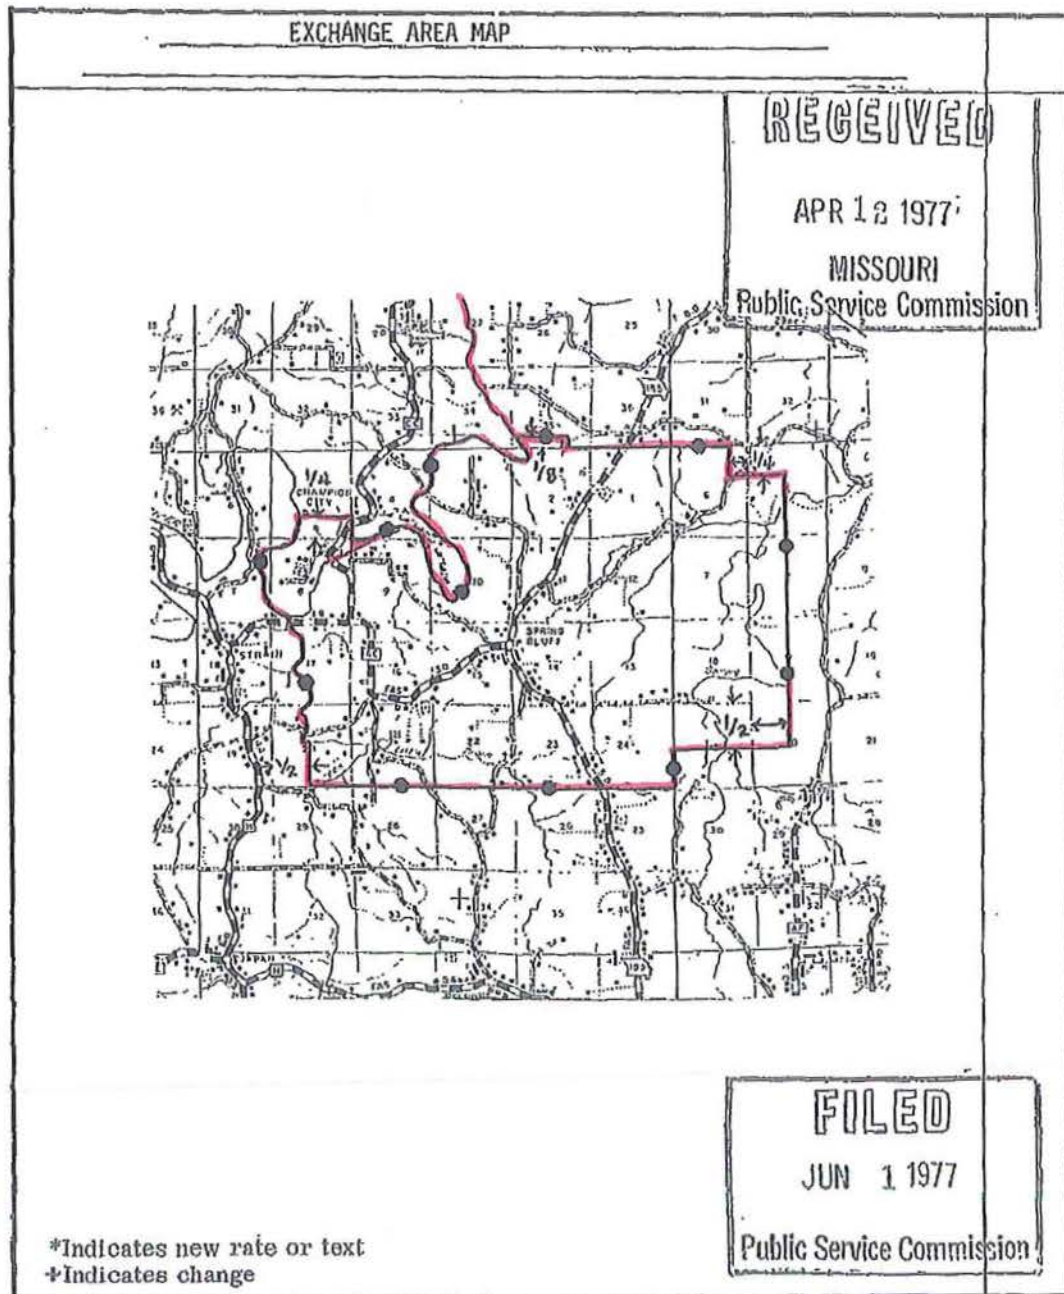

DATE OF ISSUE May 1, 1977 DATE EFFECTIVE June 1, 1977
month day year month day year
ISSUED BY Evan R. Copsey President Sullivan, MO
name of officer title address

FORM NO. 13 P.S.C.MO. No. 1 4th {Original Revised} SHEET No. 4

Cancelling P.S.C.MO. No. 1 3rd {Original Revised} SHEET No. 4

FIDELITY TELEPHONE COMPANY

Stanton, Missouri

Name of Issuing Corporation

For

Community, Town or City

Franklin County


RECEIVED

EXCHANGE AREA MAP

APR 27 1984

MISSOURI

Public Service Commission

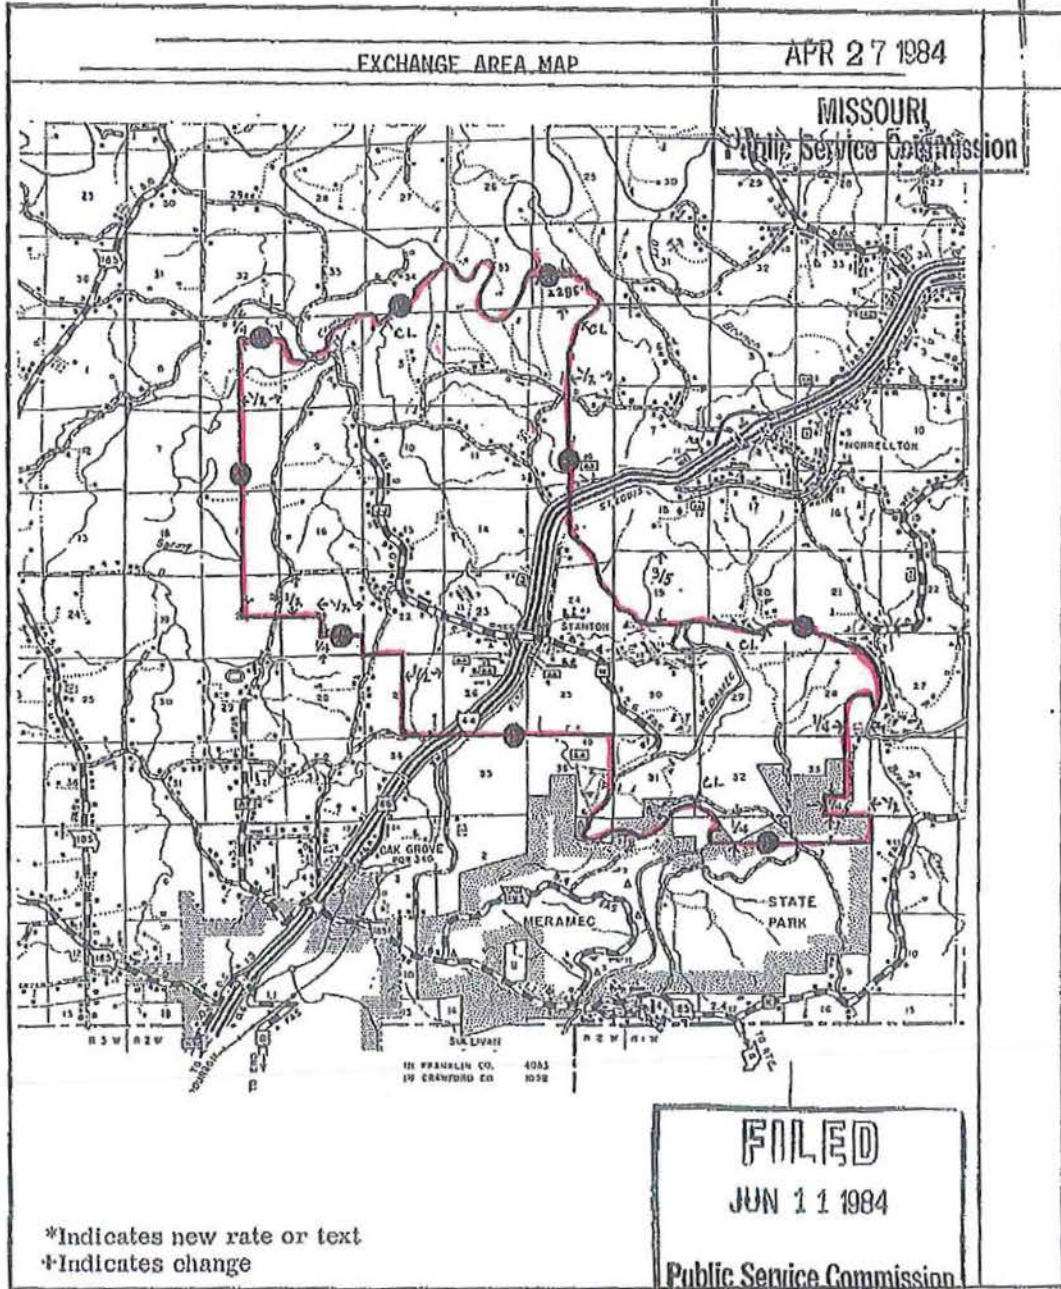

*Indicates new rate or text
+Indicates change

FILED

JUN 11 1984

Public Service Commission

DATE OF ISSUE May 10, 1984 DATE EFFECTIVE June 11, 1984
month day year month day year

ISSUED BY Evan R. Copsey President Sullivan, MO
name of officer title address